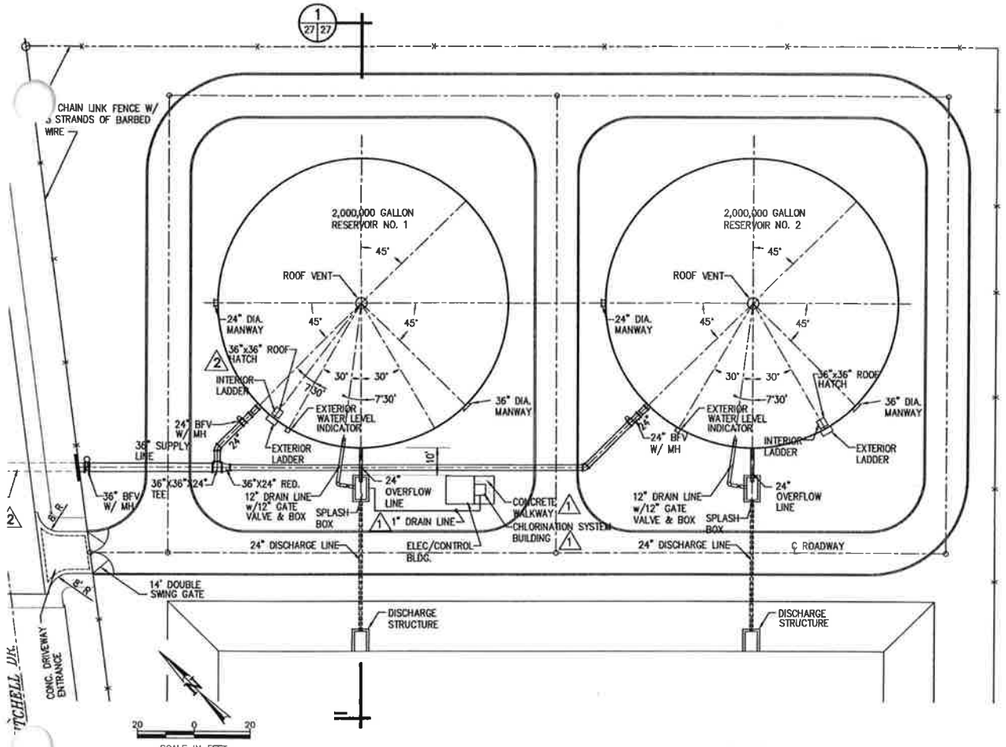

RESERVOIR PLAN
SCALE: 1" = 20'

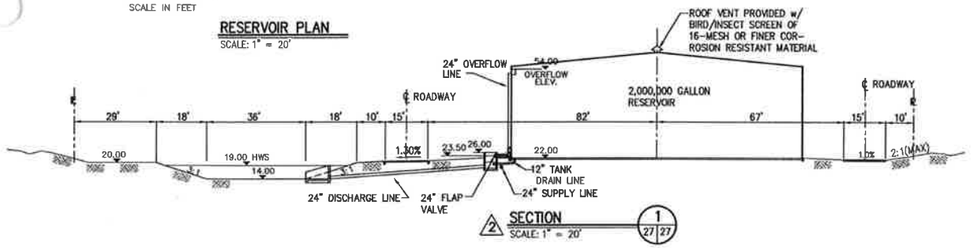

2 SECTION
SCALE: 1" = 20'
1 27|27

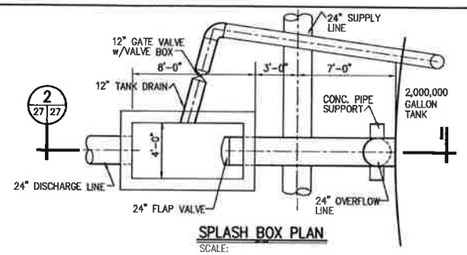

SPLASH BOX PLAN
SCALE:

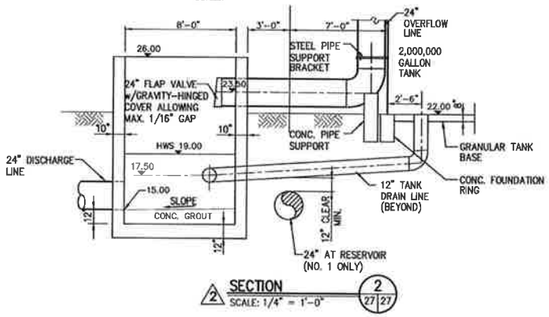

2 SECTION
SCALE: 1/4" = 1'-0"
2 27|27

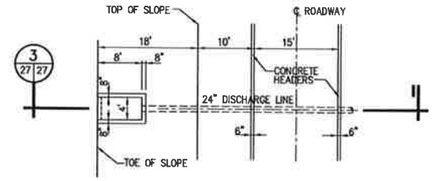

OUTLET STRUCTURE PLAN
SCALE: 1"=10'

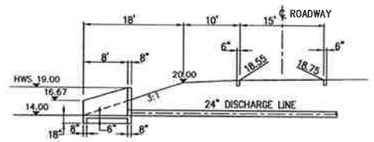

2 SECTION
SCALE: 1"=10'
3 27|27

RECORD DRAWING AUGUS

BY	DESCRIPTION
SBF	ADDED CHLOR. SYSTEM BUILDING.
JPC	PER "AS BUILT" INFORMATION

DESIGNED: SBF
DRAWN: PSC--CAD
CHECKED: STM
DATE: JULY, 1997

Designed By:

PSC Parkhill, Smith & Cooper, Inc.
Engineers • Architects • Planners
810 E. Yandell, El Paso, Texas 79902

STERLING B. THOMAS JR. 13505 STATE OF TEXAS REGISTERED PROFESSIONAL ENGINEER 9-11-97

THIS RECORD DRAWING IS A COPY OF THE SEALED CONTRACT DRAWING FOR THIS PROJECT, MODIFIED BY ADDENDA, CHANGE ORDERS, AND/OR SHOP DRAWINGS FURNISHED BY THE CONTRACTOR. THE INFORMATION SHOWN ON THIS RECORD DRAWING IS BELIEVED BY PARKHILL, SMITH & COOPER, INC. TO BE ACCURATE BASED ON OBSERVATIONS PERFORMED DURING CONSTRUCTION AND INFORMATION FURNISHED BY OTHERS. THE ORIGINAL SEALED DRAWINGS ARE ON FILE AT THE OFFICE OF PARKHILL, SMITH & COOPER, INC. 810 E. YANDELL, EL PASO, TEXAS 79902.

Lower Valley WATER DISTRICT

PROJECT: LVEDAP PHASE III PROJECT CN COMMON WATER & WASTEWATER FACILITIES PROJECT B

SHEET TITLE:

RESERVOIR EQUIPMENT SECTIONS & DETAILS